


| DO NOT SCALE | METRIC | THIRD ANGLE PROJECTION |
|---|---|---|
| DIMENSIONS IN mm | | |

| LTR. | REVISION RECORD | DR. | CHK. | DATE |
|---|---|---|---|---|
| B1 | ECO-09-026346 | KK | AEG | 26NOV09 |

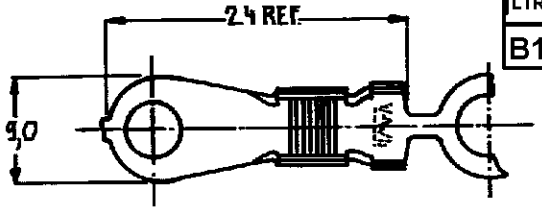


5 OBSOLETE PARTS: OBSOLETE CIS STREAMLINING PER D.RENAUD/D.SINISI

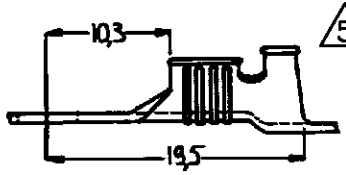

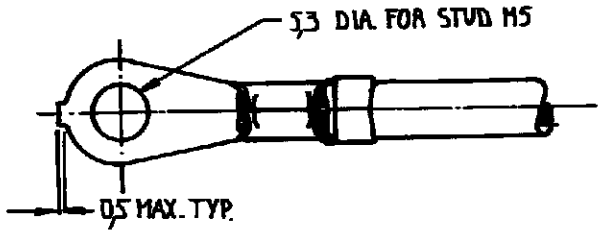



DOC. CENTRE
14 JUNI 1993

NOTES: 1 FOR USE ON STANDARD AND MINIATURE APPLICATORS
2 FOR USE ON MINIATURE APPLICATORS. (AMP-O-MATOR APPLICATION)
3 WITH PAPER COVER 4 WITH PAPER LAYER

| NOTES | FINISH | MATERIAL | PART NUMBER |
|---|---|---|---|
| 1 4 | UNPLATED | PHOSPHOR BRONZE | ~~160134-7~~ |
| 1 | TINPLATED | PHOSPHOR BRONZE | ~~160134-6~~ |
| 1 3 | UNPLATED | PHOSPHOR BRONZE | 160134-5 |
| 1 3 | UNPLATED | BRASS | ~~160134-4~~ |
| 1 | UNPLATED | PHOSPHOR BRONZE | 160134-3 |
| 1 2 | TINPLATED | BRASS | 160134-2 |
| 1 | UNPLATED | BRASS | 160134-1 |

5 OBSOLETE

5 OBSOLETE

**CUSTOMER DRAWING**

FOR REFERENCE ONLY
WILL NOT BE UPDATED

AMP | AMP-HOLLAND B.V.
's-Hertogenbosch, The Netherlands

THIS DRAWING IS UNPUBLISHED RELEASED FOR PUBLICATION , 19

© COPYRIGHT 19 BY AMP-HOLLAND B.V.
ALL INTERNATIONAL RIGHTS RESERVED.
AMP PRODUCTS MAY BE COVERED BY U.S. AND FOREIGN PATENTS AND/OR PATENTS PENDING.

| | | | |
|---|---|---|---|
| DR. 21/4.83 | WIRE RANGE 3,1 - 5,3 mm² | NAME RINGTONGUE WITH INSULATION SUPPORT | REV. DATE D M Y 26 11 09 |
| CHK. 21/4.83 | INSUL. RANGE 3,8 - 5,3 DIA. | | |
| APP. 22.4.83 | SIZE A4 / SHEET 1 OF 1 | DRAWING NO C-160134 | REV. LTR. B1 |